



RED Line - Existing Route

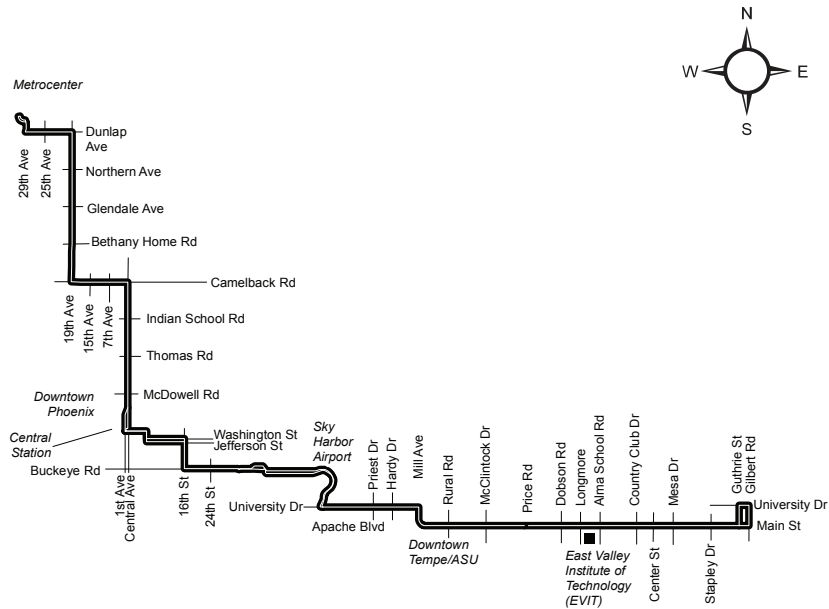

40 - Apache/Main - Proposed Route

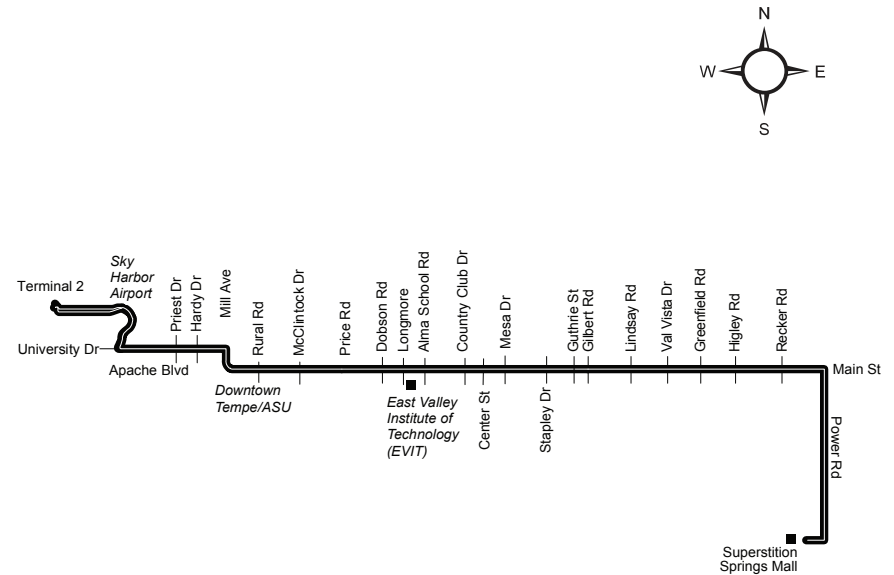

Changes:

- 1) West end of route would end at Sky Harbor Airport, Terminal 2.
- 2) East end of route would be extended to Superstition Springs Mall.
- 3) Route name would change from Red Line to 40 - Apache/Main.